


**BILL OF MATERIAL**

QTY	PIECE	DESCRIPTION	LENGTH	STEEL	REMARKS	HEIGHT	ASB
TOTAL	MARK						
ONE	B64	BEAM				2736	
1	B64	W21x93	28	A992		2605	1-16
1	p134	PL 3/8x7 1/2	1	A36			11
1	p31	PL 3/8x7	0	A36			6
2	p19	PL 1/4x22 1/2	2	A36			57
1	p22	PL 1/4x1	0	A36			1

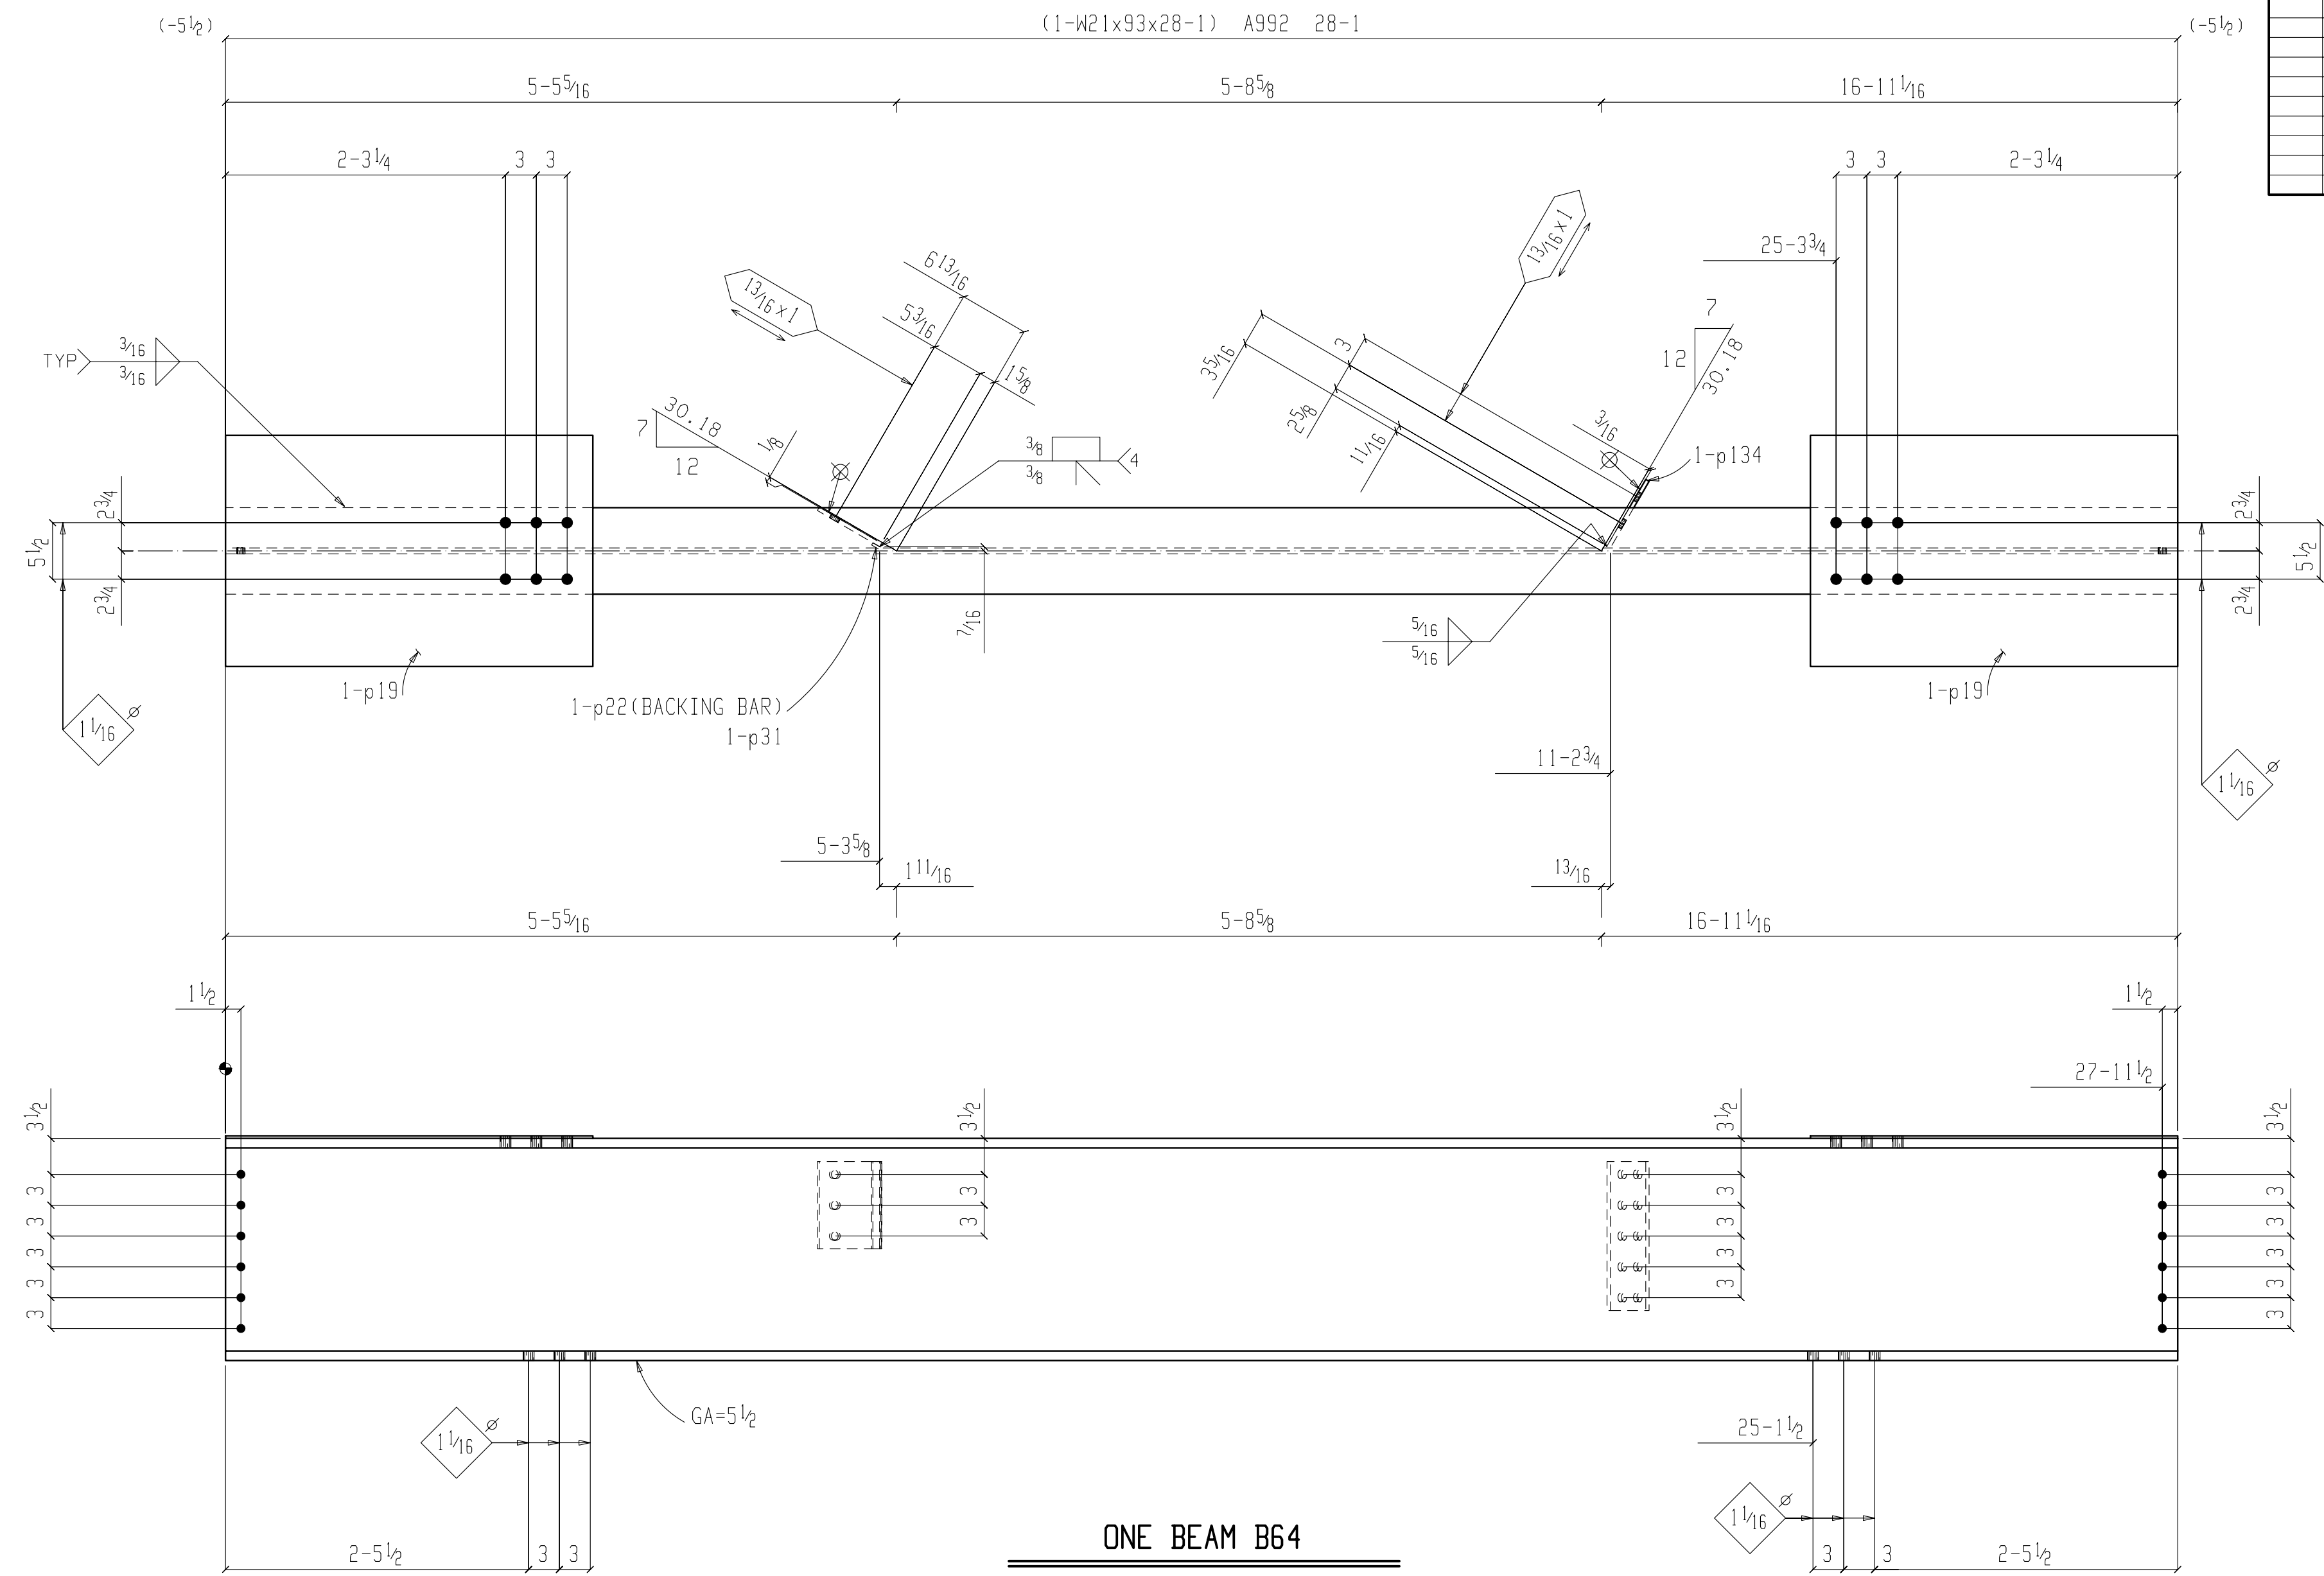

**ONE BEAM B64**

REV. ASBUILT	06-05-15
FOR FAB	04-24-15
FOR APPROVAL	03-31-15
REVISION & DATE	

HOLES: 13/16 U.N.O.	DRAWN BY: IH	PROJECT:	JOB NO.:
STEEL: A36 U.N.O.	DATE: 03-27-15	LOCATION: BALTIMORE, MD	14-21
WELDS: E70 SERIES	CHK'D BY: VP	CUSTOMER: PLANO-COUNDON, LLC	SHEET NO.:
PAINT: NO PAINT	DATE: 03-30-15	ARCHITECT: ARCHITECTURAL DESIGN WORKS	B64
		TITLE: BEAMS	

SHEET NO. B64